File Original and First Copy wit	h
Department of Ecology	
Department of Ecology Second Cupy - Owner's Copy Third Copy - Driller's Copy	

33 <sub>1</sub>	Æ.	/No.	61
-----------------	----	------	----


File Original and First Copy with Depart Sent of Ecology Second Cupy — Owner's Copy Filing Copy — Differ's Copy	WATER WE		, No 01	
(1) OWNER: Name CLAUGE D	ISLAND	Address 196W. TROXELLES	33 N. R	E WM
Bearing and distance from section or subdivision co-				
(3) PROPOSED USE: Domestic & Indus		(10) WELL LOG:		
Irrigation [ Test	Well   Other	Formation: Describe by color, character, size of mate show thickness of aquifers and the kind and nature a stratum penetrated, with at least one entry for each	rial and stru of the mater of change of	icture, and ial in each formation.
(4) TYPE OF WORK: Owner's number of (if more than one).	well	MATERIAL	FROM	то
New well  Method:	Dug Bored	HARD PAN	0	52
Deepents C	Cable Driven Dri	GRAVEL	52	65
Reconditioned 🖸	Rotary   Jetted	GRAVELY (HARD-COMPACT)	65	9/
(5) DIMENSIONS: Diameter of wel	inches.	DIRTY SAND	91_	130
Drilled 2 4 7 tt. Depth of completed	well 247 n	SANDY CLAY	/30	18/
		SAND-GANEL MIX	184	228
(6) CONSTRUCTION DETAILS:	_	LUATER IN GRAVEL	22.6	24/
Casing installed: Diam. from		HACO C. HAY	24/	247
Threaded [] "Diam. from"				
Welded P Diam. from	ft. to ft.			
Perforations: Yes D No D				<u> </u>
Type of perforator used				<u> </u>
SIZE of perforations in,	by in.			 - <del> </del> -
perforations from	ft. to ft.			
perforations from	(t. to R.			
perforations from	11. 10 11.			
Screens: Yes II No []		5 GAL PER MIN PE	C FOOT	of
Manufacturer's Name Vatantso	<u>N</u>		SAM DOW	<u> </u>
Type Welder (214/ME2) Me	odel No	WATER STATIC 227'		<u> </u>
Diam. Slot size 25 from 2	37 11. to 4.4.7- 11.	DEE 19 247'		<u> </u>
Diam. Slot size from	ft. to ft.			
Gravel packed: Yes   No D Size of	f gravel			
Gravel placed from				
Surface seal: Yes No To what	depth? 15 tm.			
Did any strata contain unusable water	r?Yes 🗍 No 🖫			
Type of water? Depth	of strata	TECHTY IN	<del></del> -	
Method of sealing strata off		DCT 0 4 10		<del> </del> -
(7) PUMP: Manufacturer's Name		001 21 1931		<del> </del>
Type: Sub	нР	Ditto co	<del></del>	<del></del>
		- BETT, UT ECOLOGY		
(8) WATER LEVELS: Land-surface elevators mean sea	level. 330 + ft.		<del></del>	+
Static level 224 ft. below top of w	ell Dates/Mah		<del></del>	· <del> </del>
Artesian pressurelbs. per square in	ch Date		<del>-  </del>	<del> </del>
Artesian water is controlled by	(Cap, valve, etc.)			
(9) WELL TESTS: Drawdown is amount to the second below at a second	unt water level is	Work started VAA 1987 Completed	(ED	1984
Was a pump test made? Yes No If yes, by	whom? PUMPS	WELL DRILLER'S STATEMENT:		
Yield: 35 gal./min. with 7 - ft. drawde			1.41.1	
<u>" 35 " 7 " " </u>	<u> </u>	This well was drilled under my jurisdicti true to the best of my knowledge and belie	on and this f.	s report 18
<u> </u>		tine to the pear of my knowledge and pene		
Recovery data (time taken as zero when pump t measured from well top to water level)  Time Water Level   Time Water Level		NAME WHIDREY DRILLE	(Type or	print)
Time Water Level Time Water Level		1		
	4	Address ON HARON WAI	<i>f</i>	
Date of test FEB E4		[Signed] Hanni Fala	m	
Bailer test 10 gal/min. with 2 ft. draw	rdown after hrs.	(Well Driller)	. (	۵

License No 129

Date AN

Artesian flow......g.p.m. Date......

Temperature of water....... Was a chemical analysis made? Yes No []

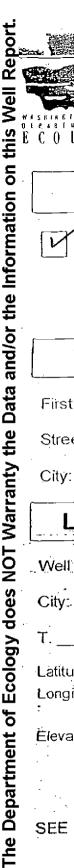



## Well Tagging Form

Unique Well Tag No:\_AGA570

## RECORD VERIFICATION (check ✓one)

Well Report available (please attach this form to the well report and submit it to the Ecology Regional Office near you).

If a well report is not available, please complete a "Water Well Report for an Existing Well" form. This form is available at Ecology's headquarters office. Do not use this form for wells that do not have a Water Well Report.

WELL OWNERSHIP, IF DIFFERENT FROM WELL REPORT
First Name: Fort Knox Mobile Home Park
Street Address: 4655 N. Park Acres Drive
city: Oak Hawhor State: WA 98272
LOCATION OF WELL, IF DIFFERENT FROM WELL REPORT
Well Address: 4695 Pork Acres Drive, Parcel R 13301-350-2950
Well Address: 4695 Pouk Acres Drive farcel R 13301-350-2950  City: Oak Harbor County: Island
T. 33 N. R. 01 E W.M. Sec. 1 5W 1/4 of the NE
Latitude $\frac{48.22}{5299}$ $\frac{78448}{52999}$
Elevation at land surface

SEE BACK SIDE OF PAGE...

RECEIVED

JUL 17 2012

DEPT OF ECOLOGY NWRO - WR

WELL CHARACTERISTICS	S
strapped to well come (	in pit west of reserv
	4.
Scale 1:24,000 (1" = 2,000')	
Indicate the location of the well within the	Section by drawing a dot at that point
SECTION	सुध
y P Q R	Property (See Section 1988)
DMMENTS:	·
	en en indiana i i i i i i i i i i i i i i i i i i
	A Street of the
	and the same of th